
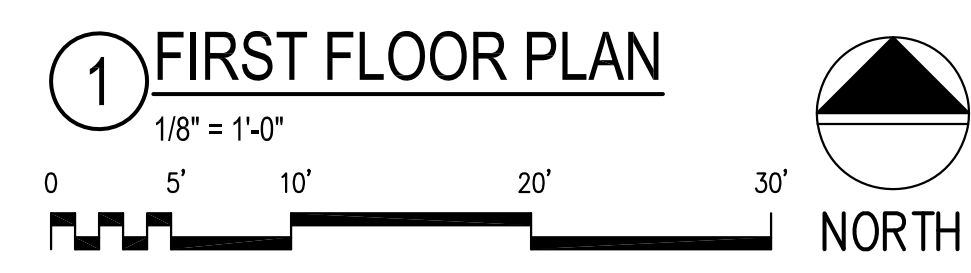


SOUTH 405 PLACE

900 SOUTHWEST 16TH STREET
RENTON, WASHINGTON 98057

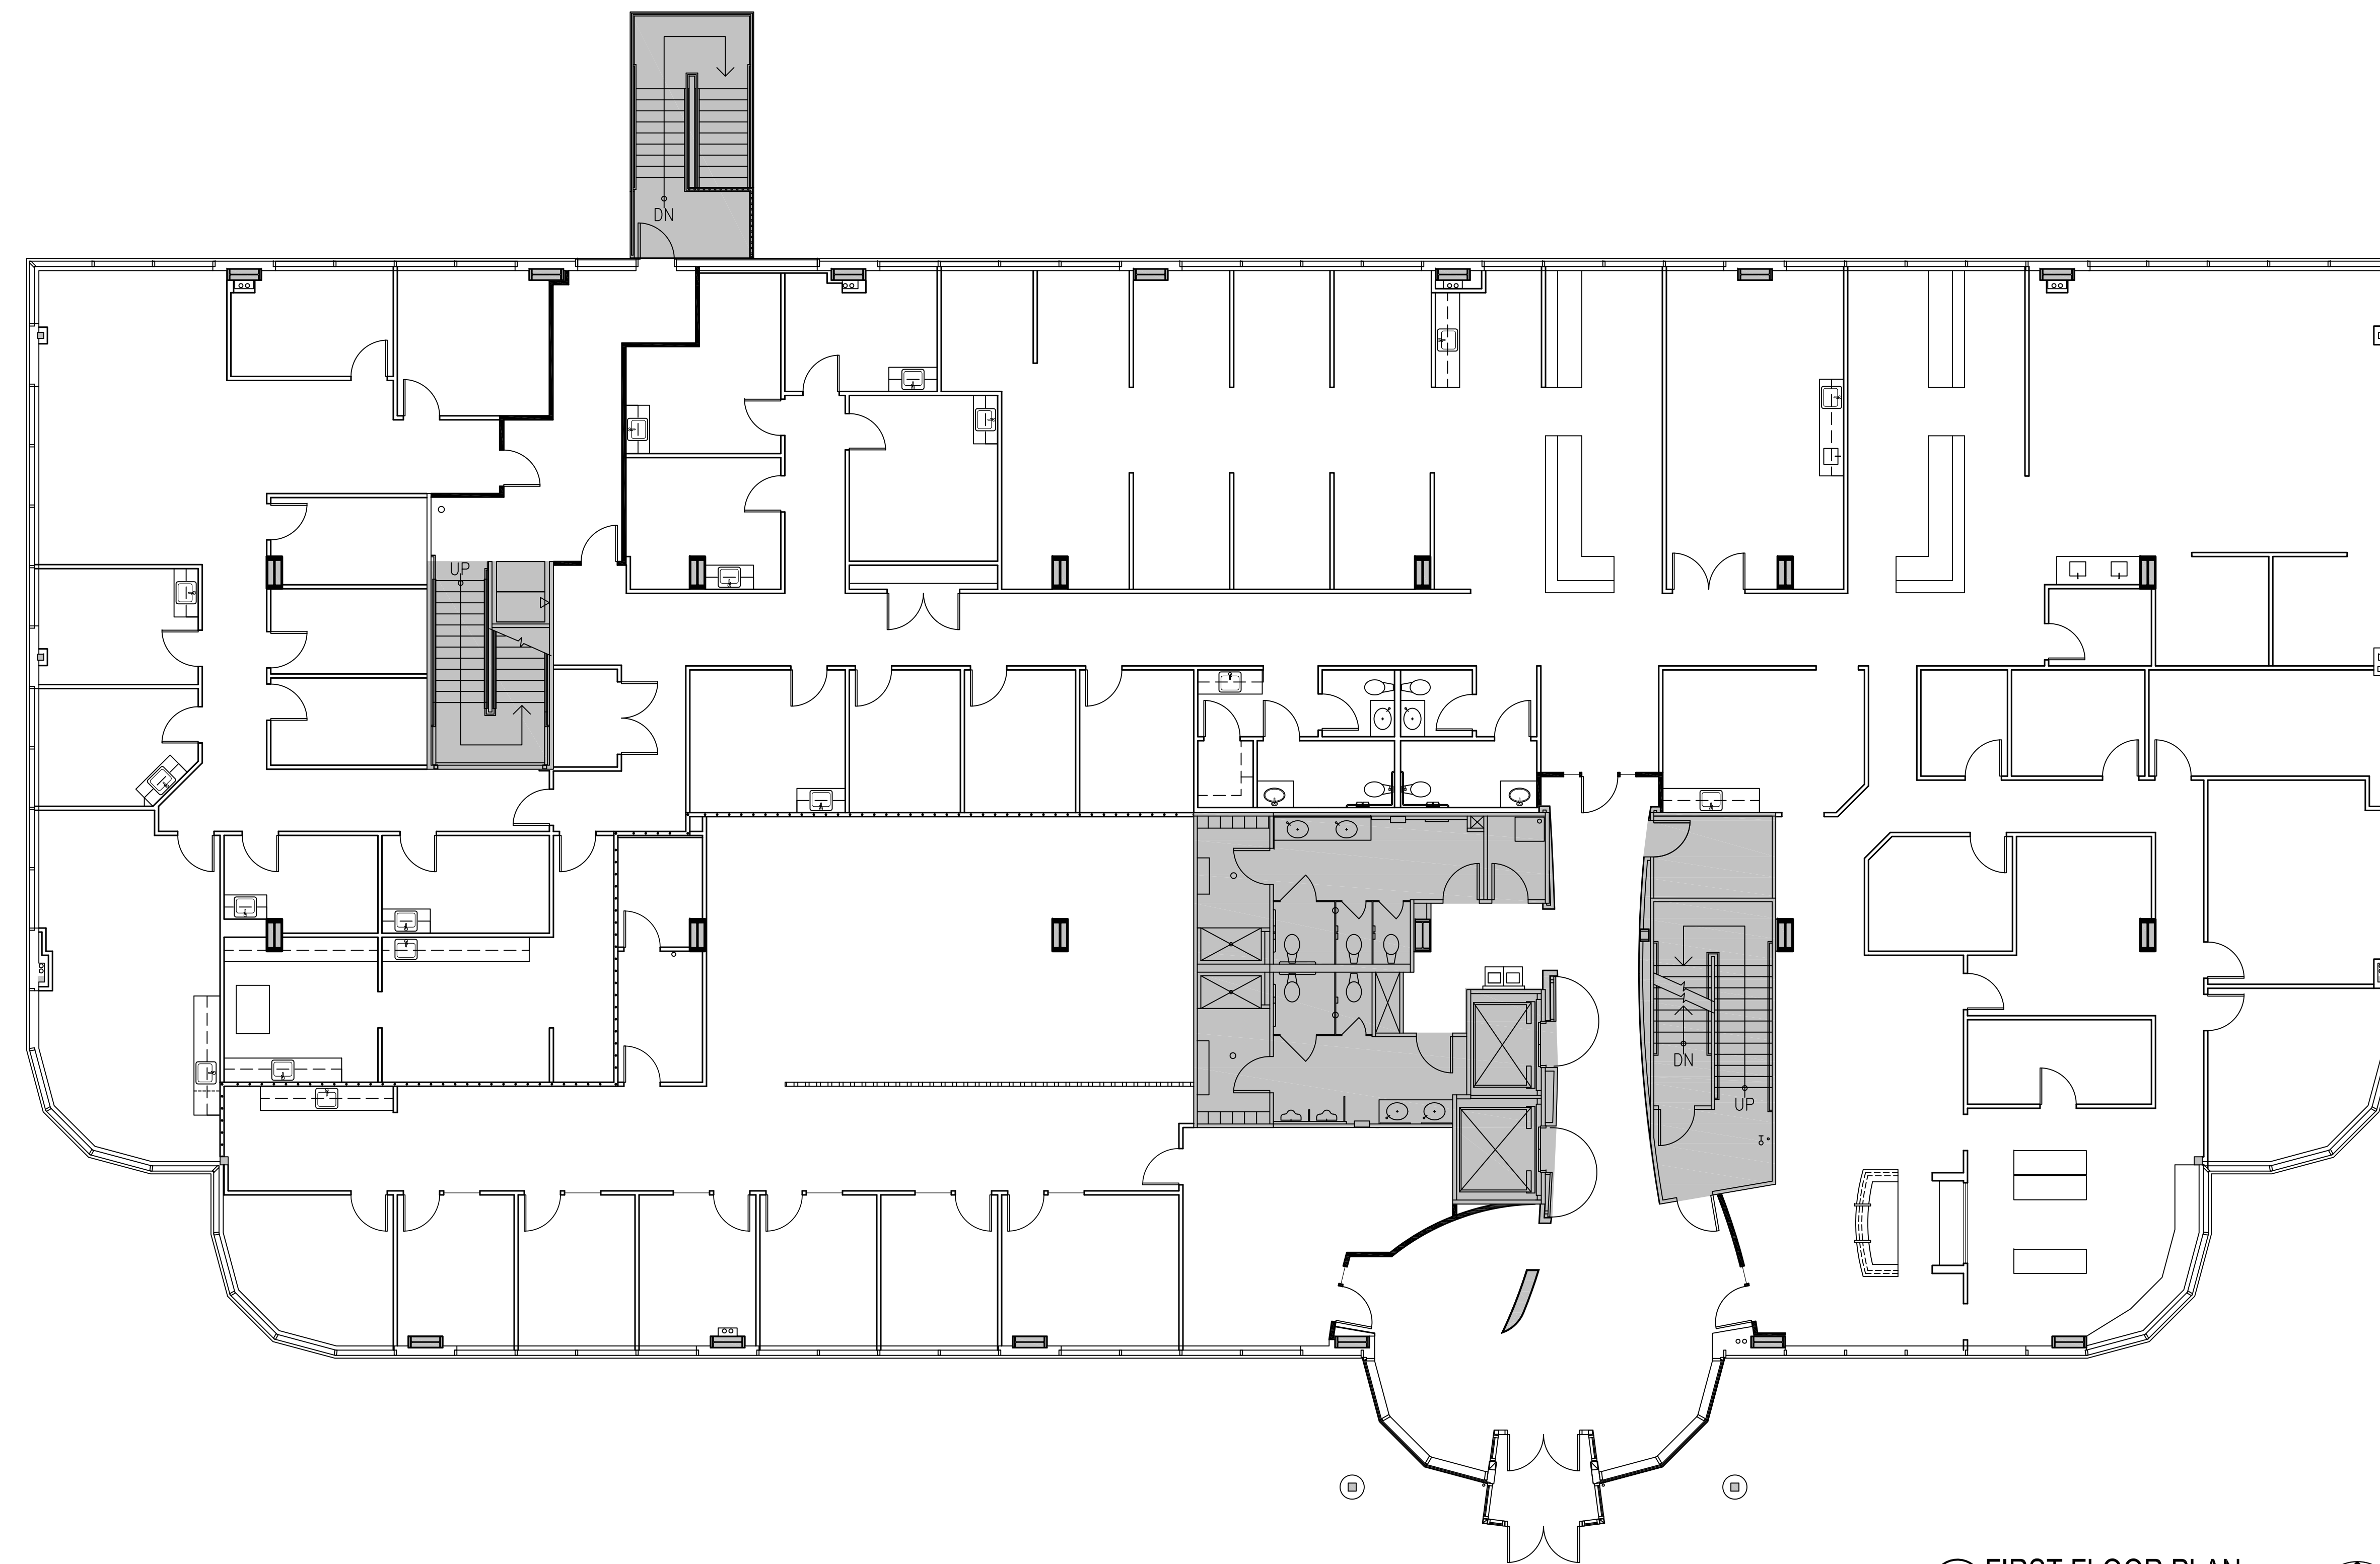

MSA
MARVIN STEIN ASSOCIATES
2221 FIFTH AVENUE, SEATTLE WA 98121

DRAWN BY:

CHECKED BY:

JOB NO.:

NO.	REVISIONS INDICATED THUS	DATE	BY

TENANT:

SHEET TITLE:


**FIRST FLOOR
ASBULT**

REPRODUCTION, ALTERATION OR PUBLICATION OF THIS DRAWING WITHOUT EXPRESSED PERMISSION BY MSA&A, IS A VIOLATION OF FEDERAL COPYRIGHT LAW. COPYRIGHT BY MSA&A 2012.

Date: Mar 11, 2013
Time: 12:00 PM
Drawing File: 3:\ALUDSS\3-2\South 405 Place\MS-buils\S0405-AB-01.dwg
User: S2405-MA-01

SOUTH 405 PLACE

900 SOUTHWEST 16TH STREET
RENTON, WASHINGTON 98057

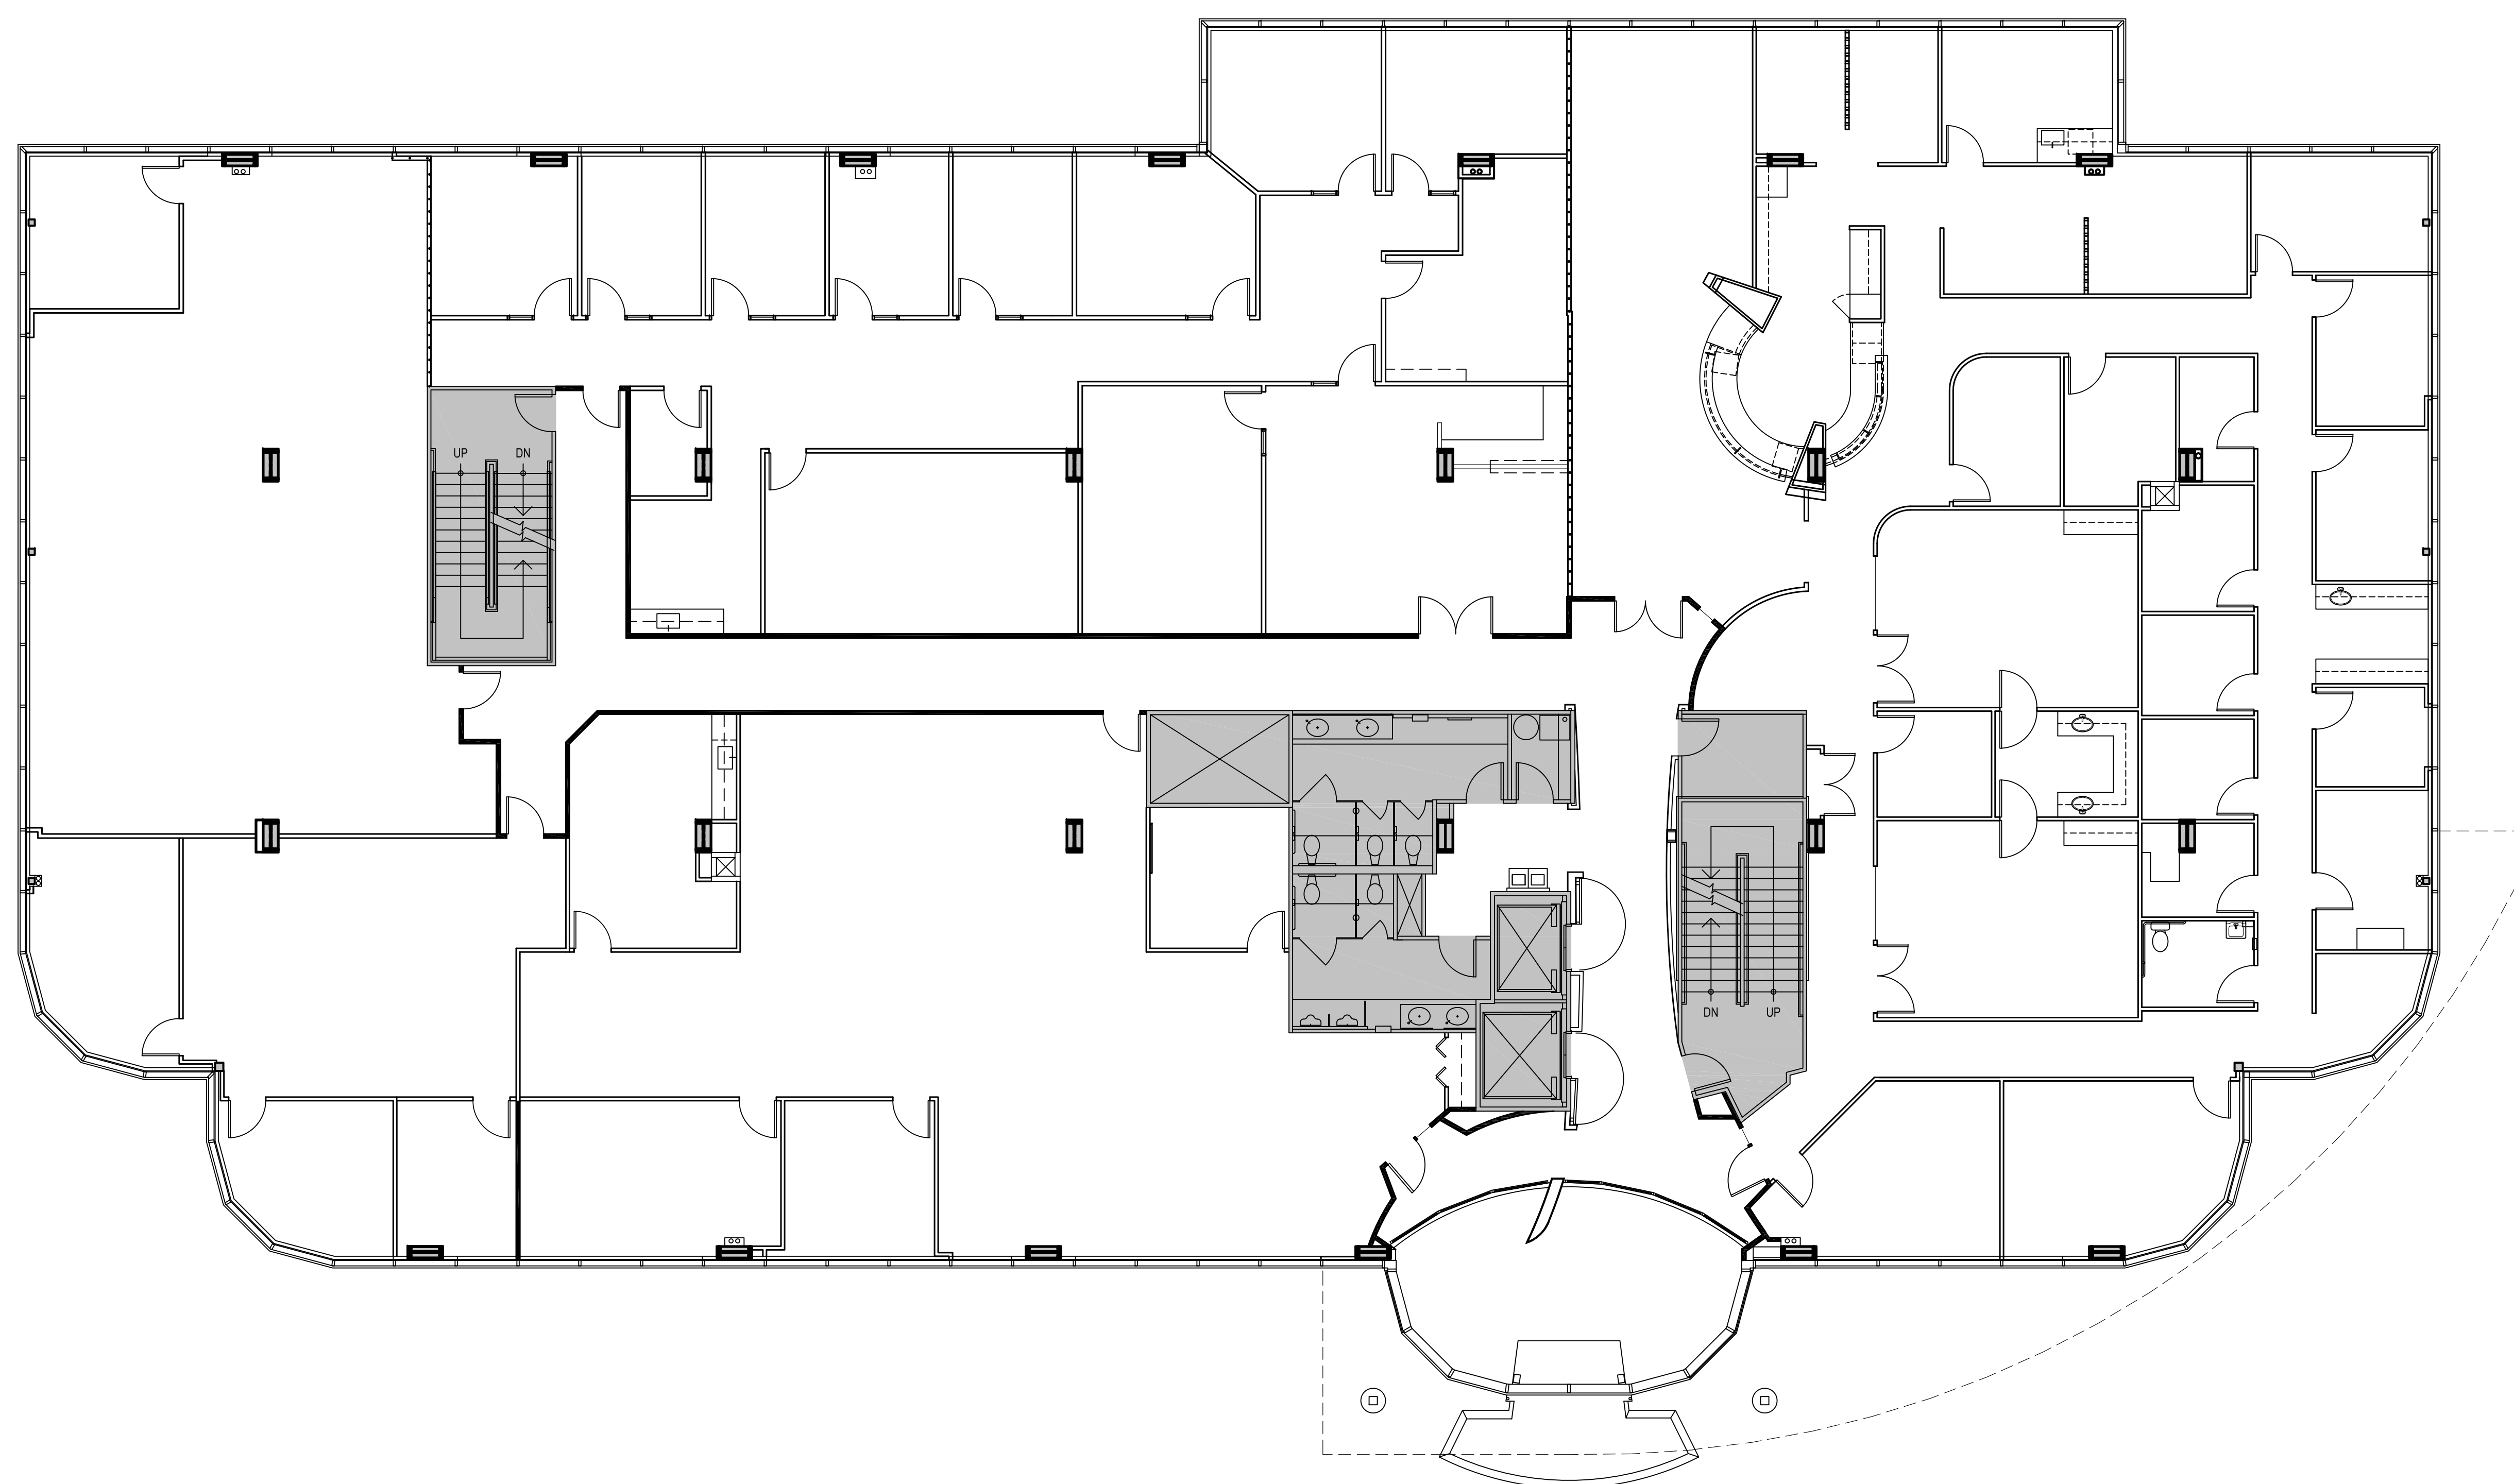

1 SECOND FLOOR PLAN
1/8"=1'-0"
0 5' 10' 20' 30'
NORTH

MSA
MARVIN STEIN ASSOCIATES
2221 FIFTH AVENUE, SEATTLE WA 98121

DRAWN BY:
CHECKED BY:
JOB NO.:

NO.	REVISIONS INDICATED THUS	DATE	BY

TENANT:

SHEET TITLE:


SECOND FLOOR
ASBUILT

Date: Mar 11, 2013
Time: 12:30pm
Drawing File: S:\Projects\South 405 Place\MSA-buila\S0405-AB-02.dwg
User: S2405-MA-02

F00T DENT 1

SOUTH 405 PLACE

900 SOUTHWEST 16TH STREET
RENTON, WASHINGTON 98057

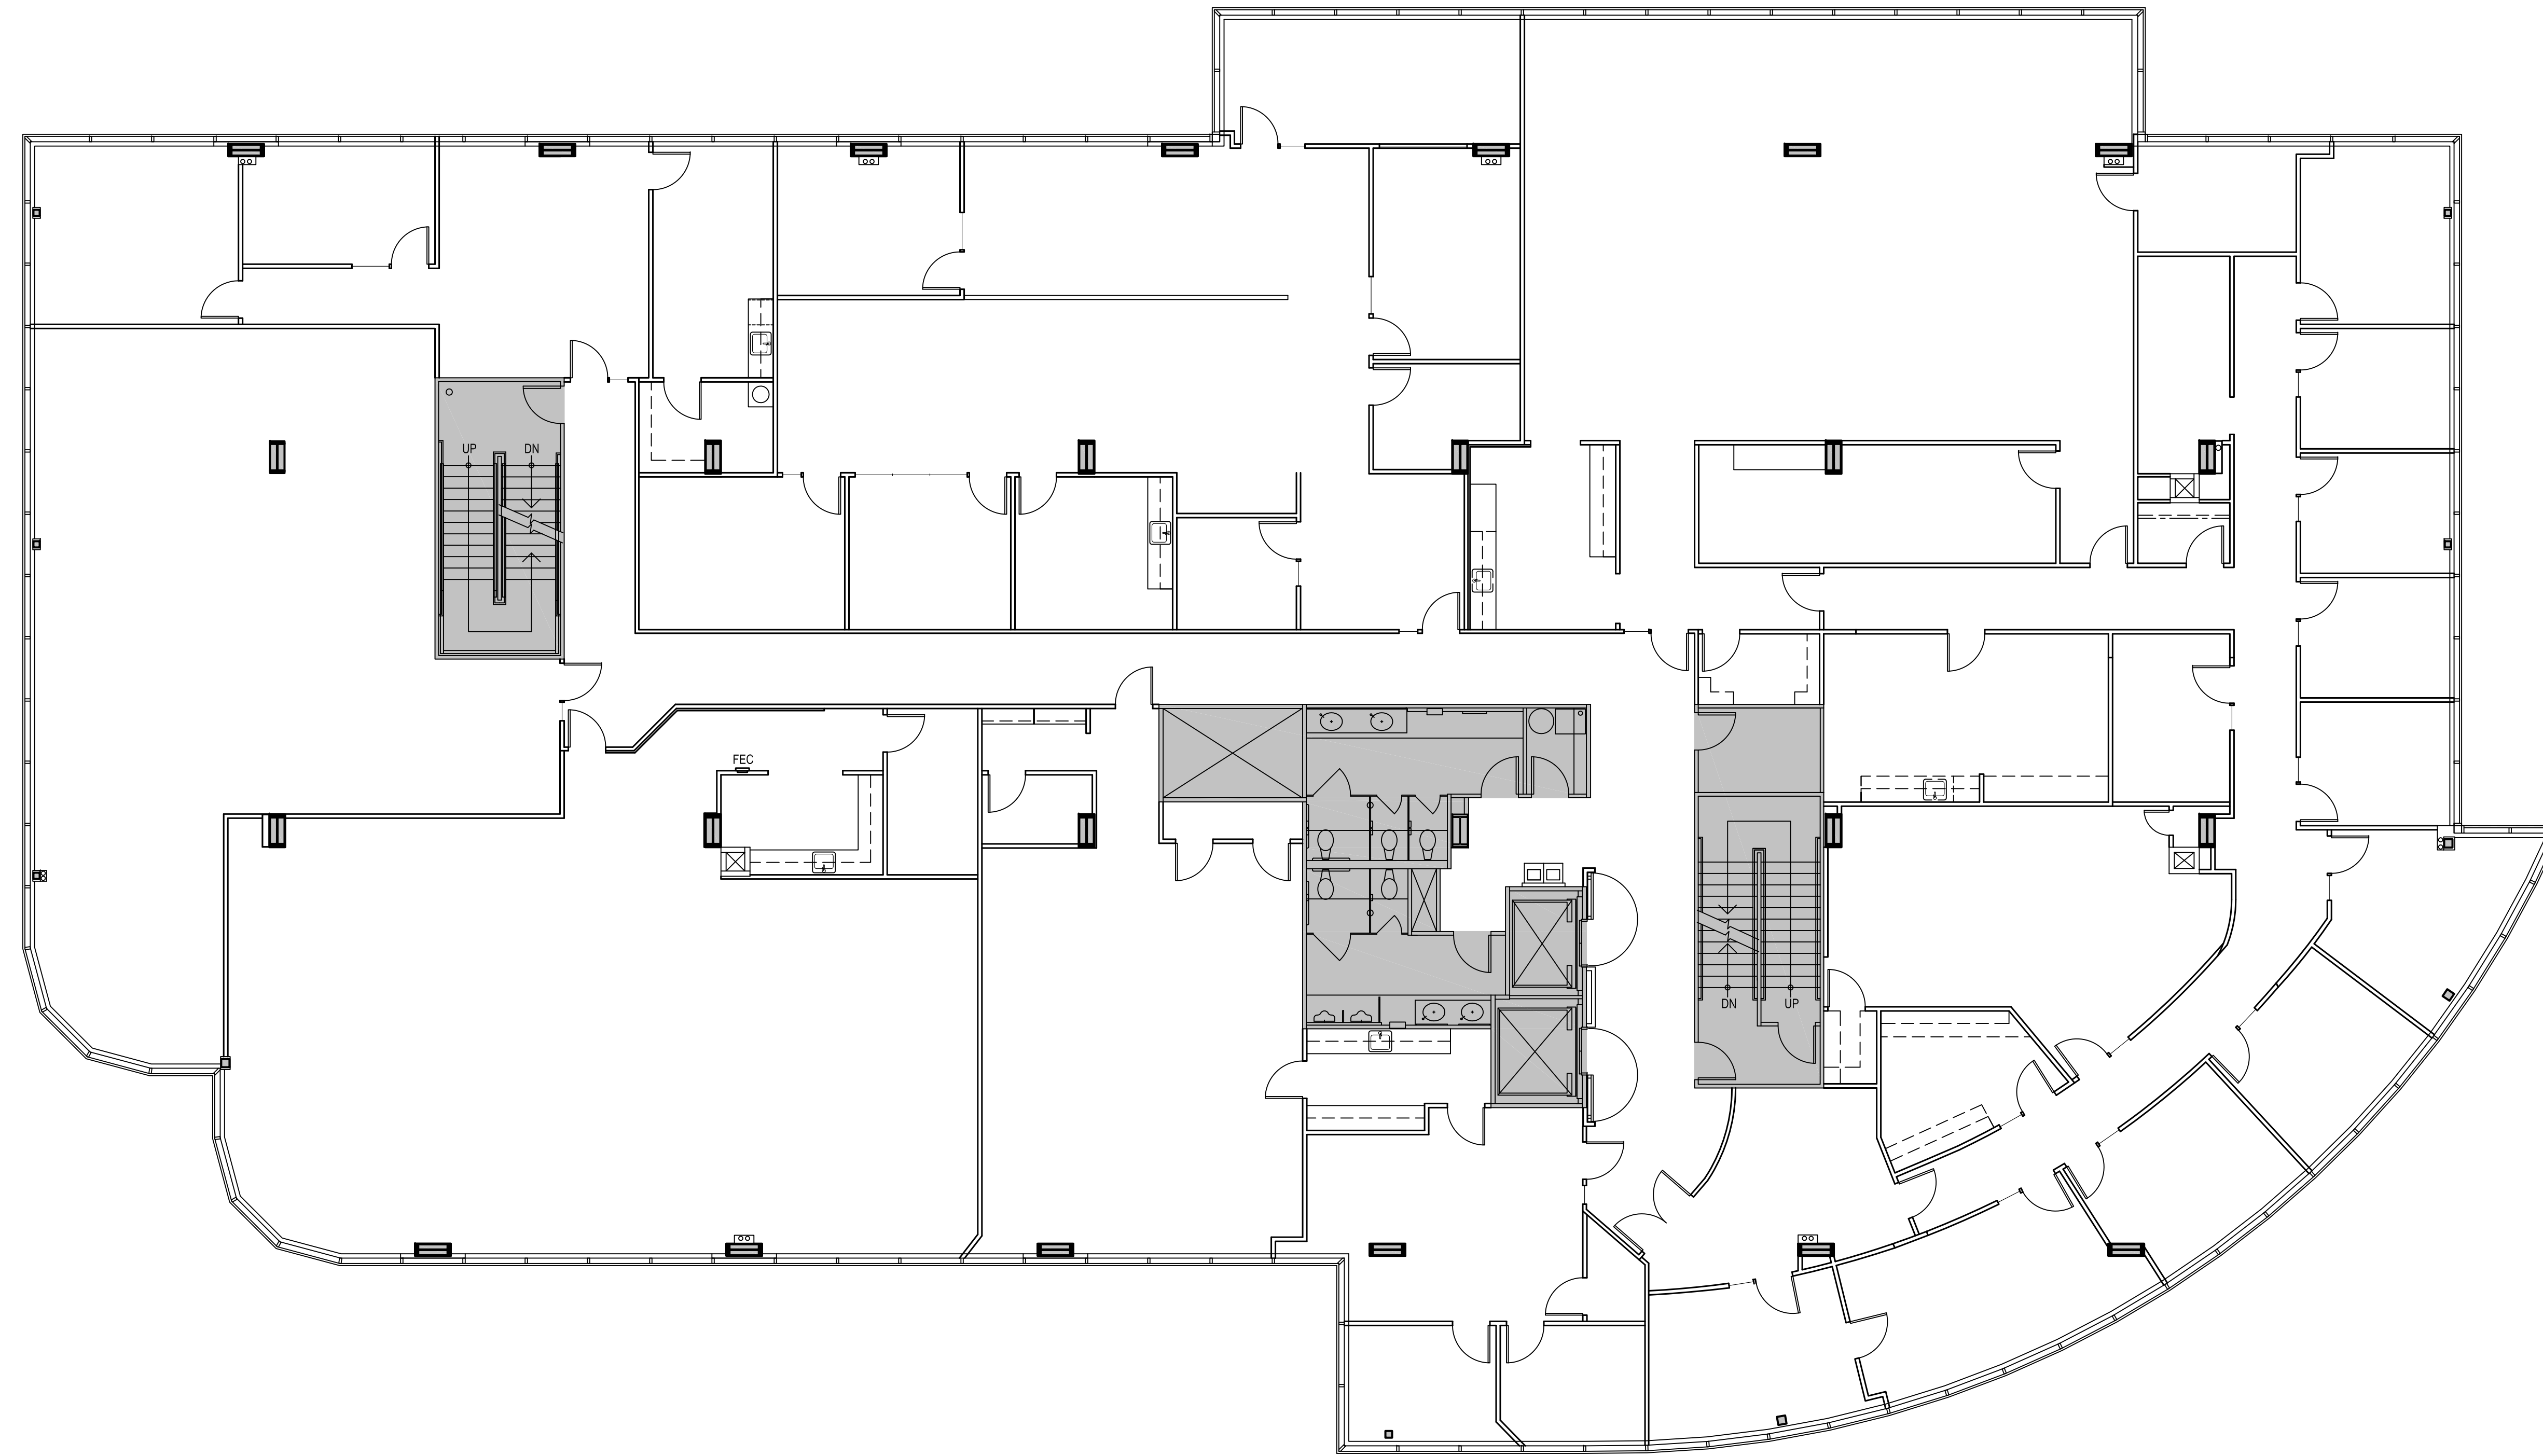

1 THIRD FLOOR PLAN
1/8"=1'-0"
0 5' 10' 20' 30'
NORTH

MSA
MARVIN STEIN ASSOCIATES
2221 FIFTH AVENUE, SEATTLE WA 98121

DRAWN BY:

CHECKED BY:

JOB NO.:

NO.	REVISIONS INDICATED THUS \triangle	DATE	BY

TENANT:

SHEET TITLE:

**THIRD FLOOR
ASBUILT**

REPRODUCTION, ALTERATION OR PUBLICATION OF THIS
DRAWING WITHOUT EXPRESSED PERMISSION BY MSA&A, IS
A VIOLATION OF FEDERAL COPYRIGHT LAW. COPYRIGHT
BY MSA&A 2012.

Date: Mar 11, 2013
Time: 12:38:00 PM
Drawing File: P:\BUILDINGS-2\South 405 Place\MS-buils\SO405-AB-03.dwg
User: S2405-MA-13